


# UTV-Bauer Bradford & Huddersfield Local DAB

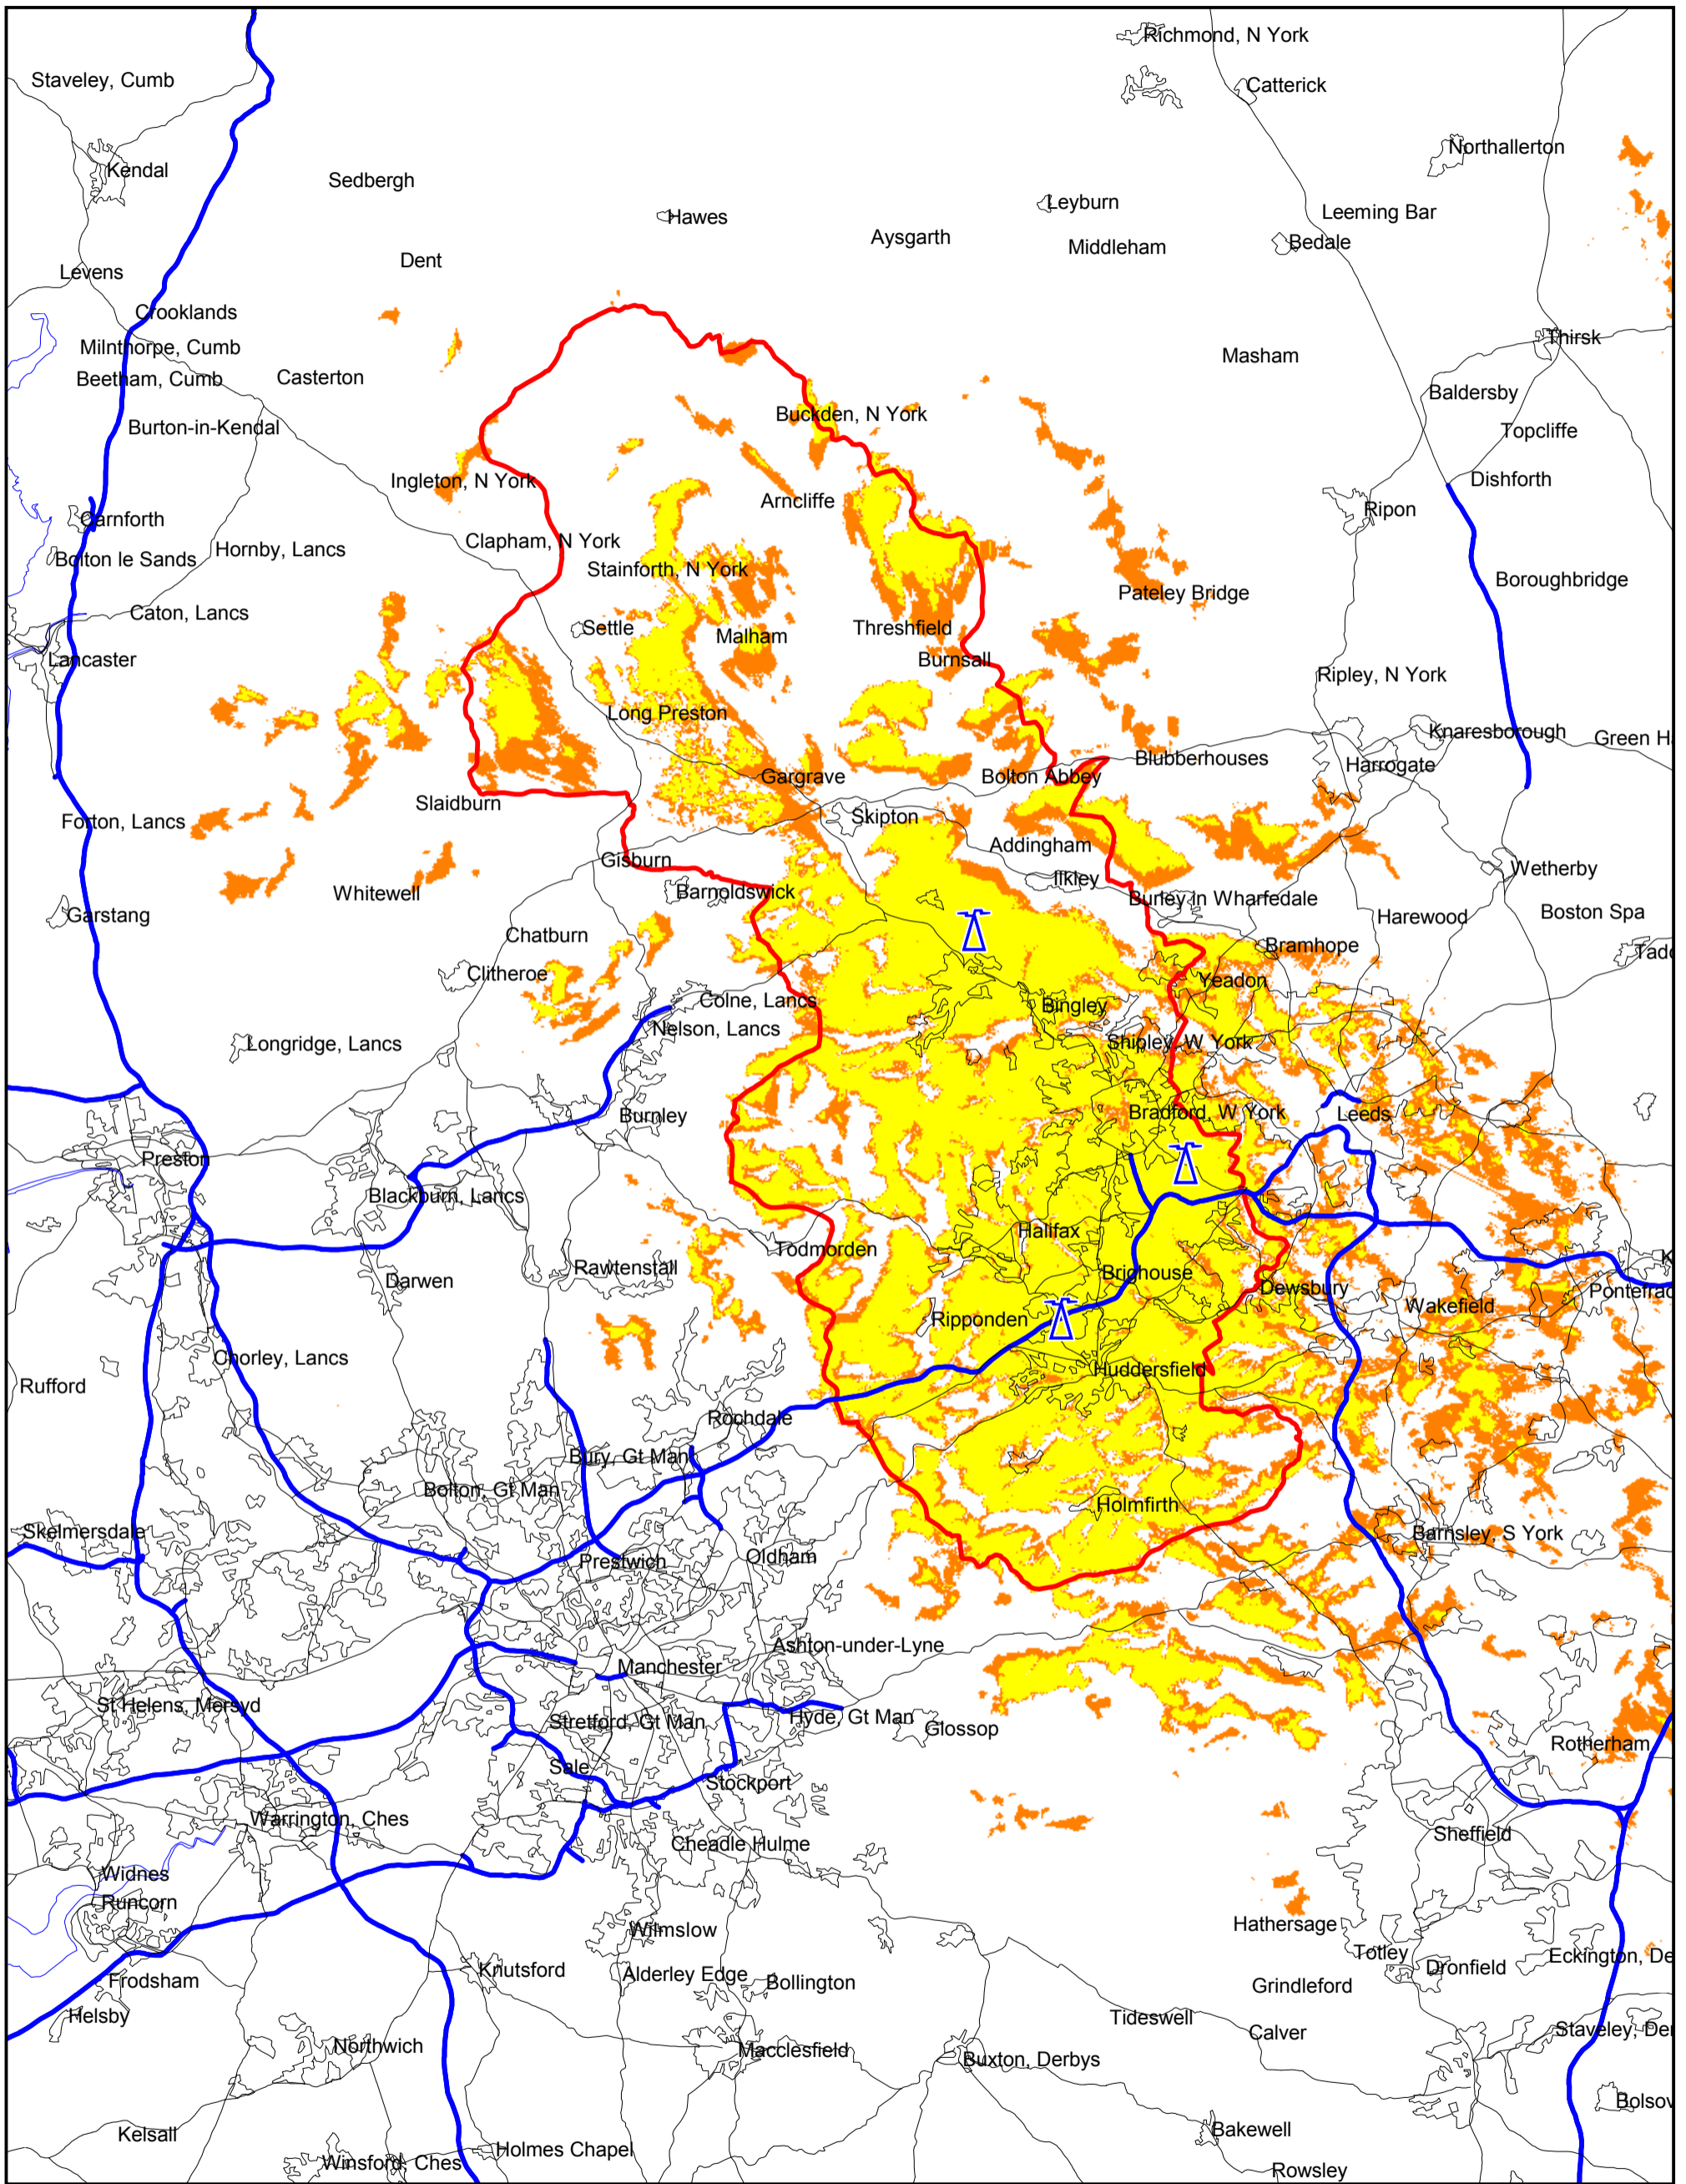

TRANSMIT PARAMETERS				LEVEL		NETWORK INFORMATION		PLOT INFORMATION	
Site Name	Antenna	Ant Ht	ERP	65 dBuV/m	684,606 77.3%	Rx Ant Height	: 10 metres a.g.l.	Plot Date	: 23 July 2009
Ainley Top	Dipoles	62m	1kW	58 dBuV/m	755,970 85.4%	Time	: 50%	Engineer	: Jack FitzSimons
Keighley	Panels	45m	1kW	15+ population derived from postcode information		Block	: 11B		
Westgate Hill	Cardioids	26m	1.61kW						

## Existing DAB Coverage

This plot shows predicted coverage. Actual coverage may differ.  
Map © 1999 The Automobile Association. All Rights Reserved.  
© 2009 Arqiva.